


# Tank Valve Box

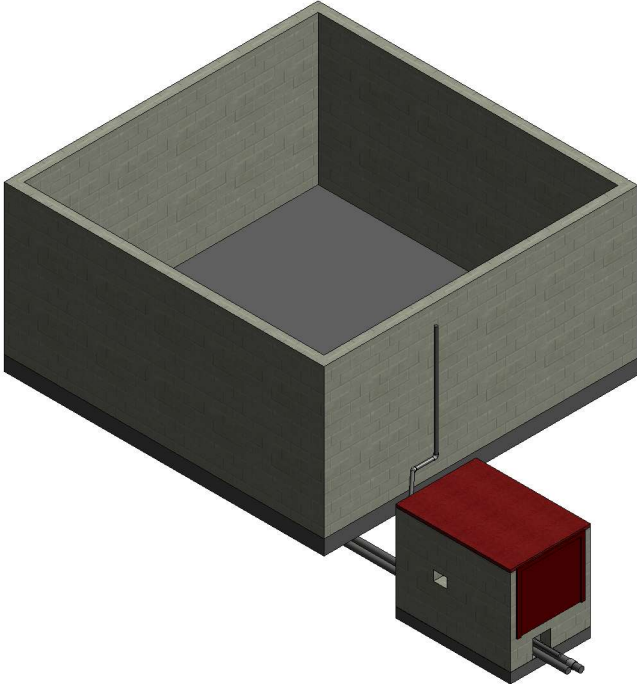

ENGINEERS WITHOUT BORDERS  
Los Sanchez Team  
Harvard College  
Cambridge, MA



[www.autodesk.com/eit](http://www.autodesk.com/eit)

Consultant  
Address  
Address  
Phone

Consultant  
Address  
Address  
Phone

No.	Description	Date

Harvard University  
Los Sanchez Water  
Distribution Project

TITLE SHEET

Project Number AS-BUILT 1

Date 2/23/2018

Drawn By Billy Koech

Checked By


A101

Scale

Sheet List	
Sheet Name	Sheet Number


TITLE SHEET	A101
DRAWING INDEX	A102
PLAN VIEW	A103
ELEVATIONS	A104
VALVE BOX DIMENSIONS	A105
HOLE DIMENSIONS	A106
PIPING DIMENSIONS	A107
3D PIPE CONNECTIONS	A110
PIPE ELEVATION VIEWS	A109
ALTA GRACIA PIPING DIMENSIONS	A108

Google Maps Los Sanchez

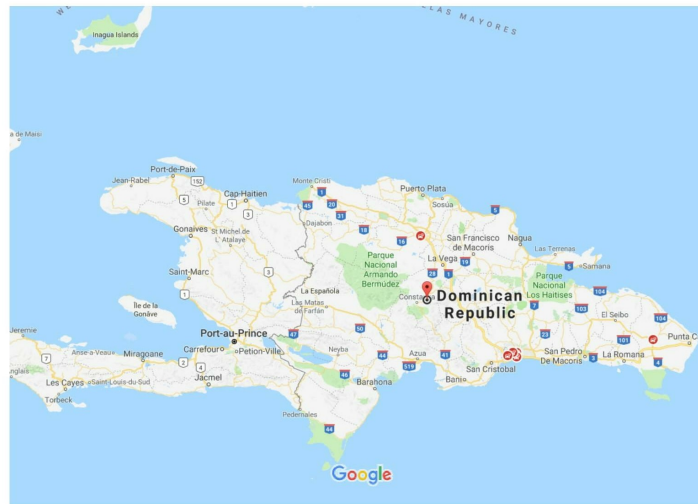

Map data ©2018 Google 20 mi

Google Maps Zoomed in map of Los Sanchez

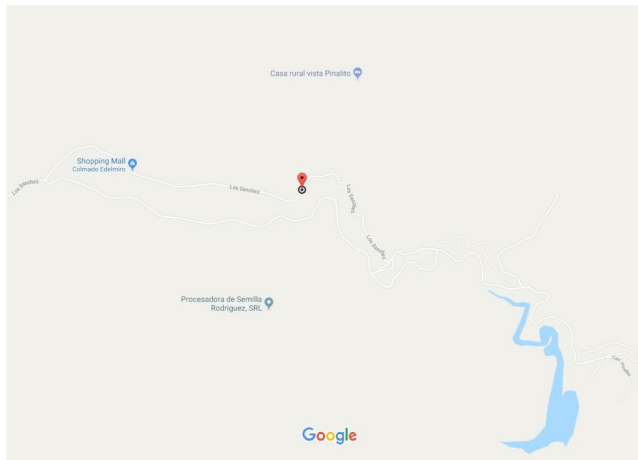

Map data ©2018 Google 1000 ft



www.autodesk.com/eit

Consultant  
Address  
Address  
Phone

Consultant  
Address  
Address  
Phone

No.	Description	Date

Harvard University  
Los Sanchez Water  
Distribution Project  
DRAWING INDEX

Project Number AS-BUILT 1

Date 2/23/2018

Drawn By Billy Koech

Checked By

**A102**

Scale

3/22/2018 12:06:12 PM



www.autodesk.com/euit

Consultant  
Address  
Address  
Phone

Consultant  
Address  
Address  
Phone

Consultant  
Address  
Address  
Phone

Consultant  
Address  
Address  
Phone


Consultant  
Address  
Address  
Phone

No.	Description	Date

**Harvard University  
Los Sanchez Water  
Distribution Project**

**PLAN VIEW**

Project Number	AS-BUILT 1
Date	2/23/2018
Drawn By	Billy Koech
Checked By	
<b>A103</b>	
Scale	1 : 15

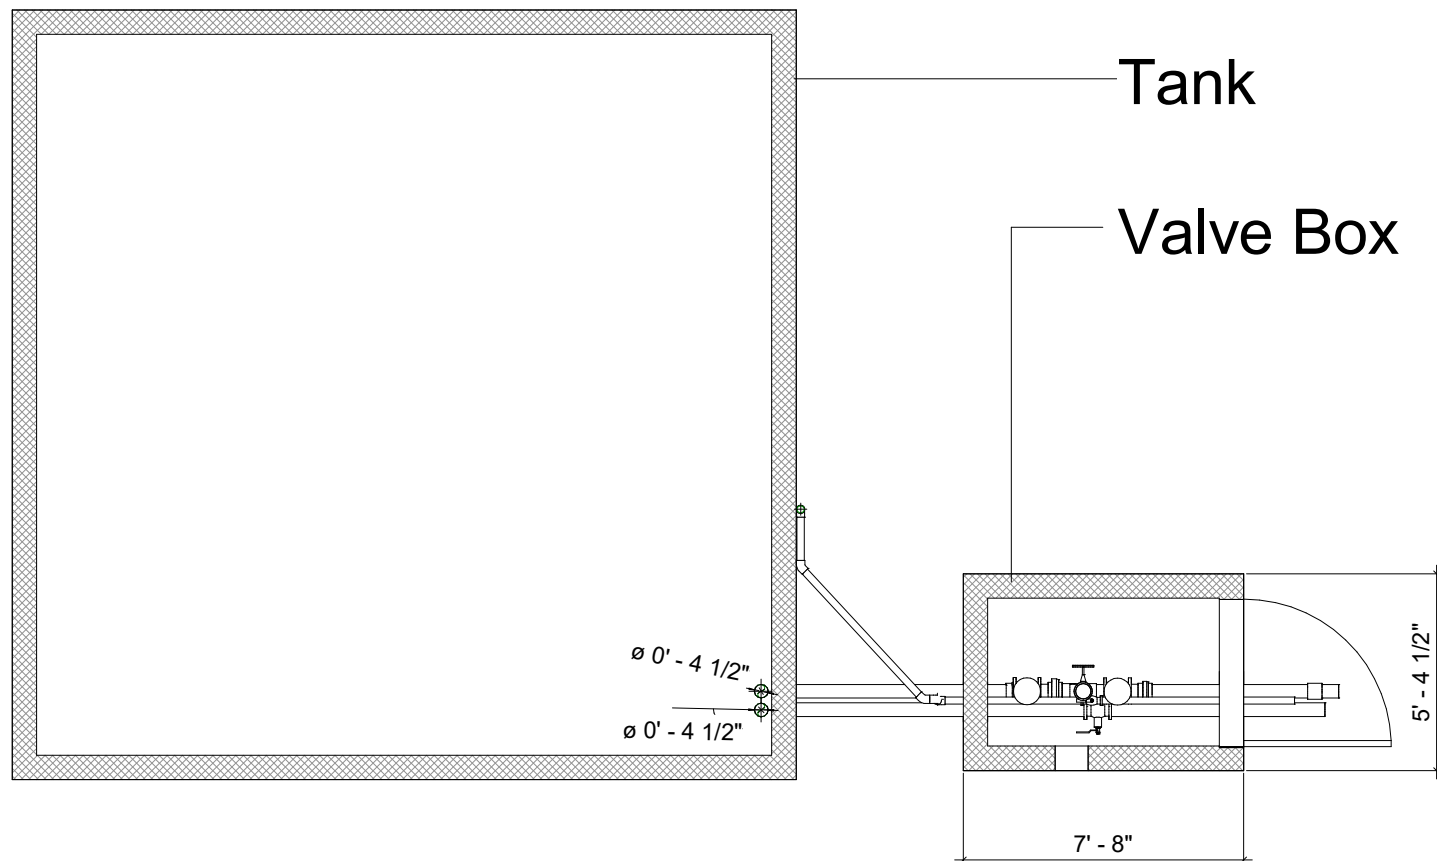



www.autodesk.com/euit

Consultant  
Address  
Address  
Phone

Consultant  
Address  
Address  
Phone

No.	Description	Date


**Harvard University  
Los Sanchez Water  
Distribution Project  
ELEVATIONS**

Project Number AS-BUILT 1  
Date 2/23/2018  
Drawn By Billy Koech  
Checked By

**A104**

Scale 1 : 30

3/2/2018 12:06:16 PM

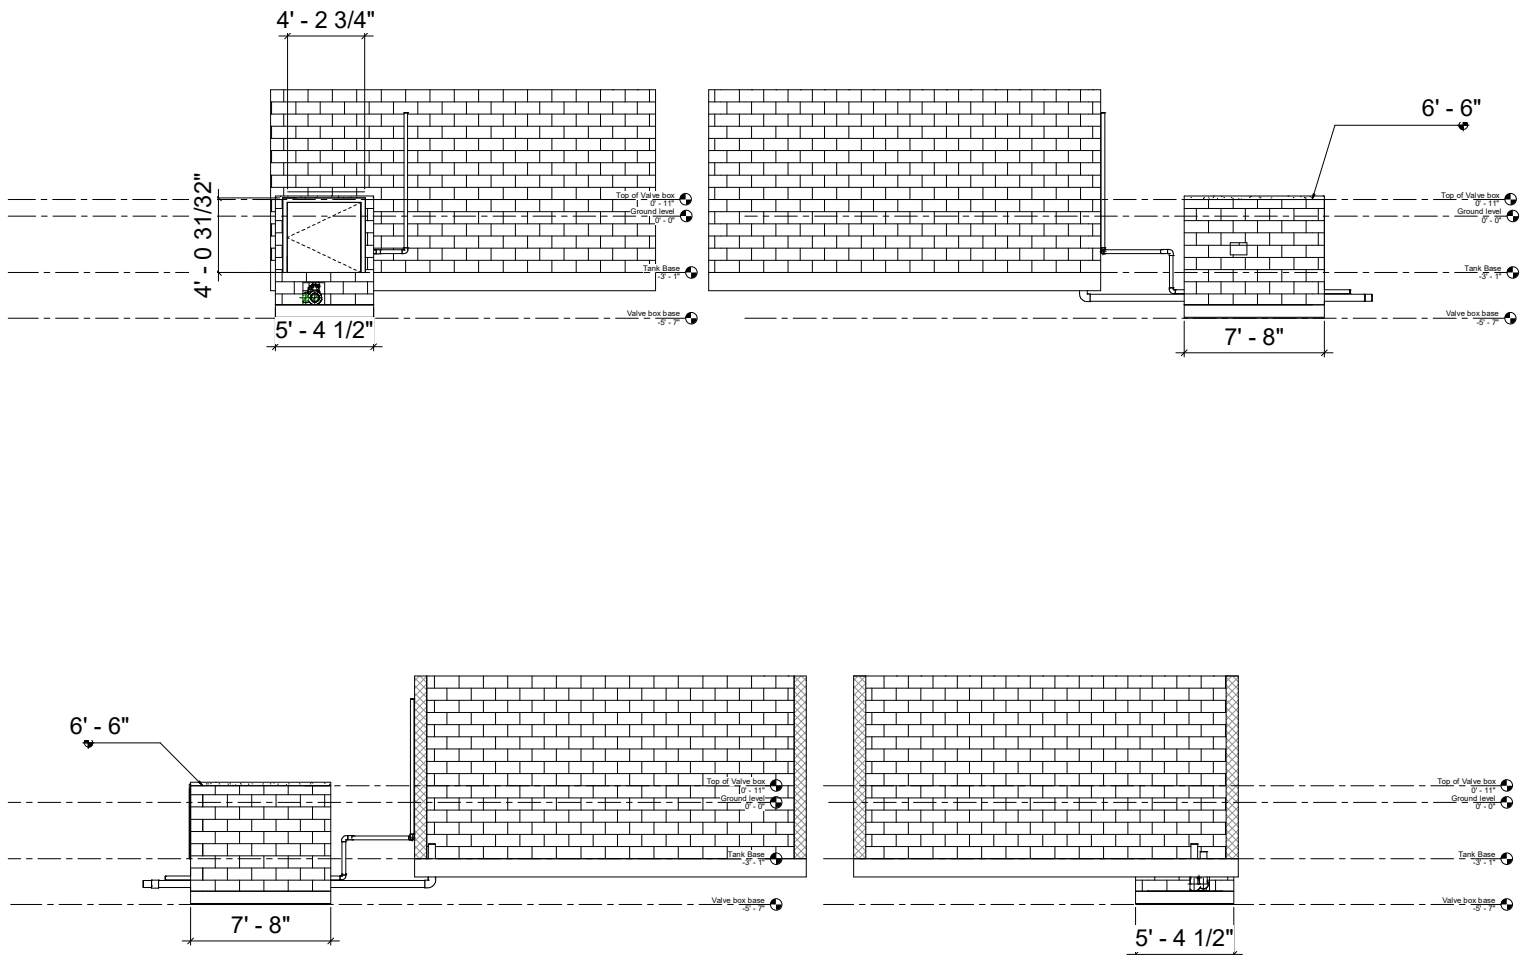



www.autodesk.com/evit


Consultant  
Address  
Address  
Address  
Phone

Consultant  
Address  
Address  
Address  
Phone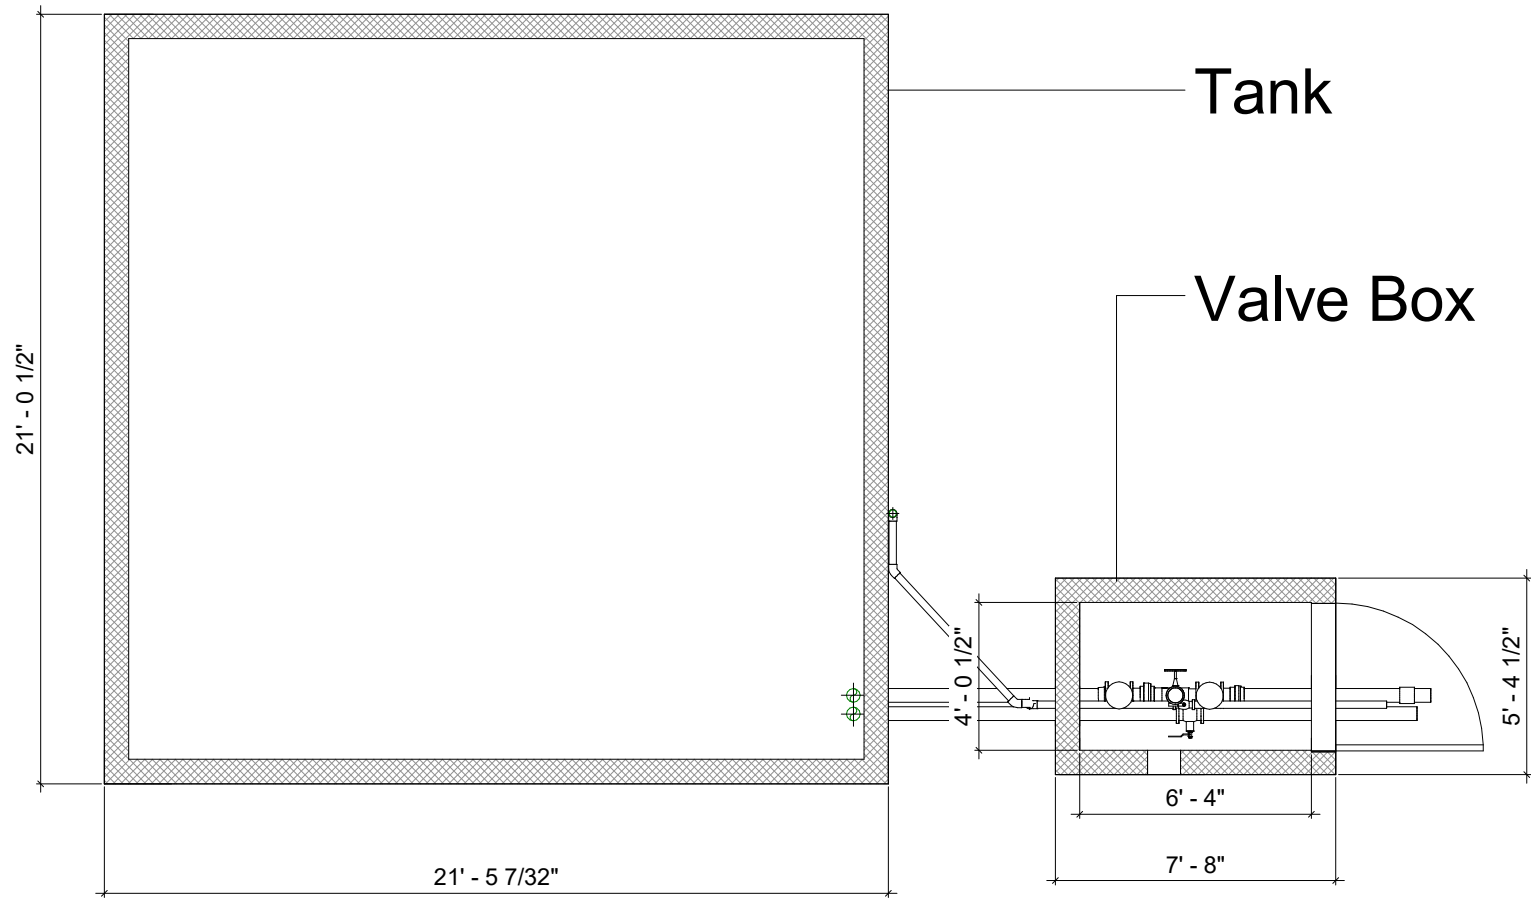

No.	Description	Date

Harvard University  
Los Sanchez Water  
Distribution Project  
**VALVE BOX  
DIMENSIONS**

Project Number AS-BUILT 1  
Date 2/23/2018  
Drawn By Billy Koech  
Checked By

A105  
Scale 1 : 15



www.autodesk.com/eut

Consultant  
Address  
Address  
Address  
Phone

Consultant  
Address  
Address  
Address  
Phone

No.	Description	Date

Harvard University  
Los Sanchez Water  
Distribution Project







**HOLE DIMENSIONS**

Project Number AS-BUILT 1  
Date 2/23/2018  
Drawn By Billy Koech  
Checked By

**A106**

Scale As indicated

3/2/2018 10:08:21 PM

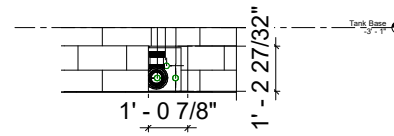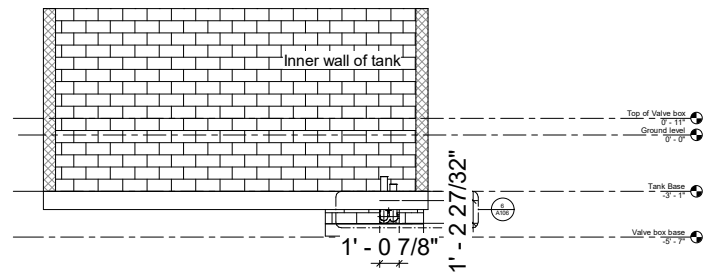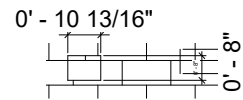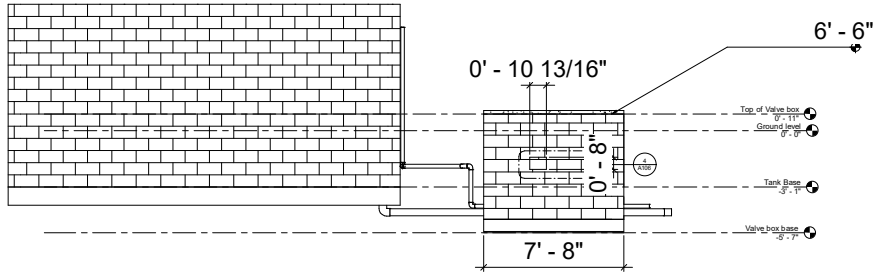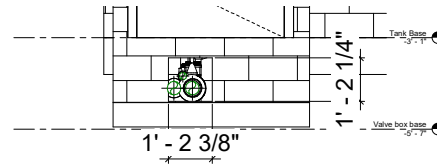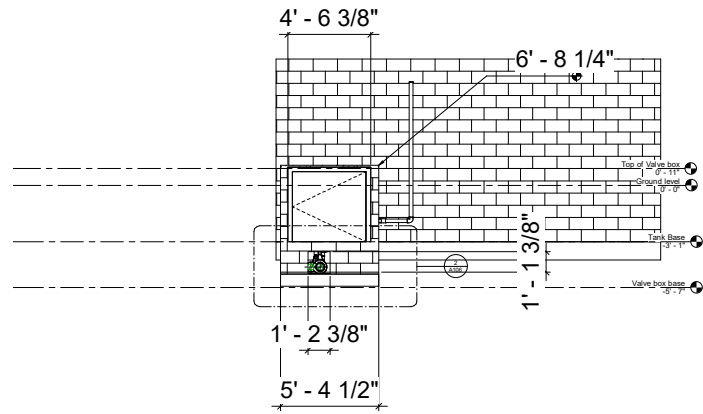



www.autodesk.com/euit

Consultant  
Address  
Address  
Phone

Consultant  
Address  
Address  
Phone

No.	Description	Date

**Harvard University**  
**Los Sanchez Water Distribution Project**

**PIPING DIMENSIONS**

Project Number	AS-BUILT 1
Date	2/23/2018
Drawn By	Billy Koech
Checked By	

**A107**  
Scale 1 : 10

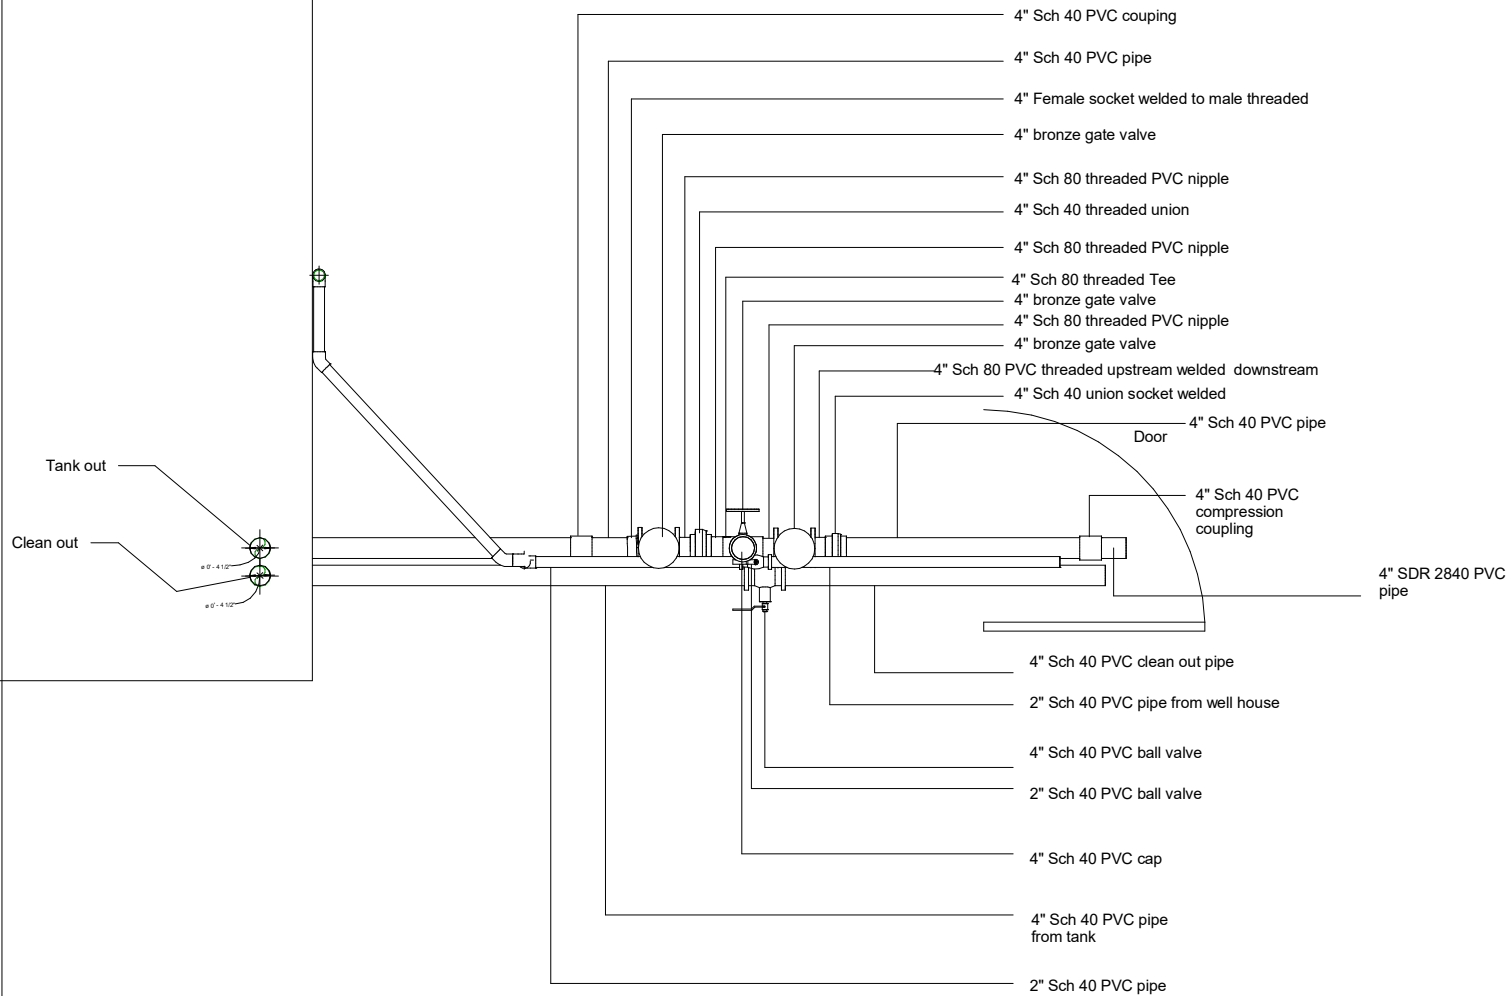

3/2/2018 12:05:22 PM



www.autodesk.com/ewit


Consultant  
Address  
Address  
Phone

Consultant  
Address  
Address  
Phone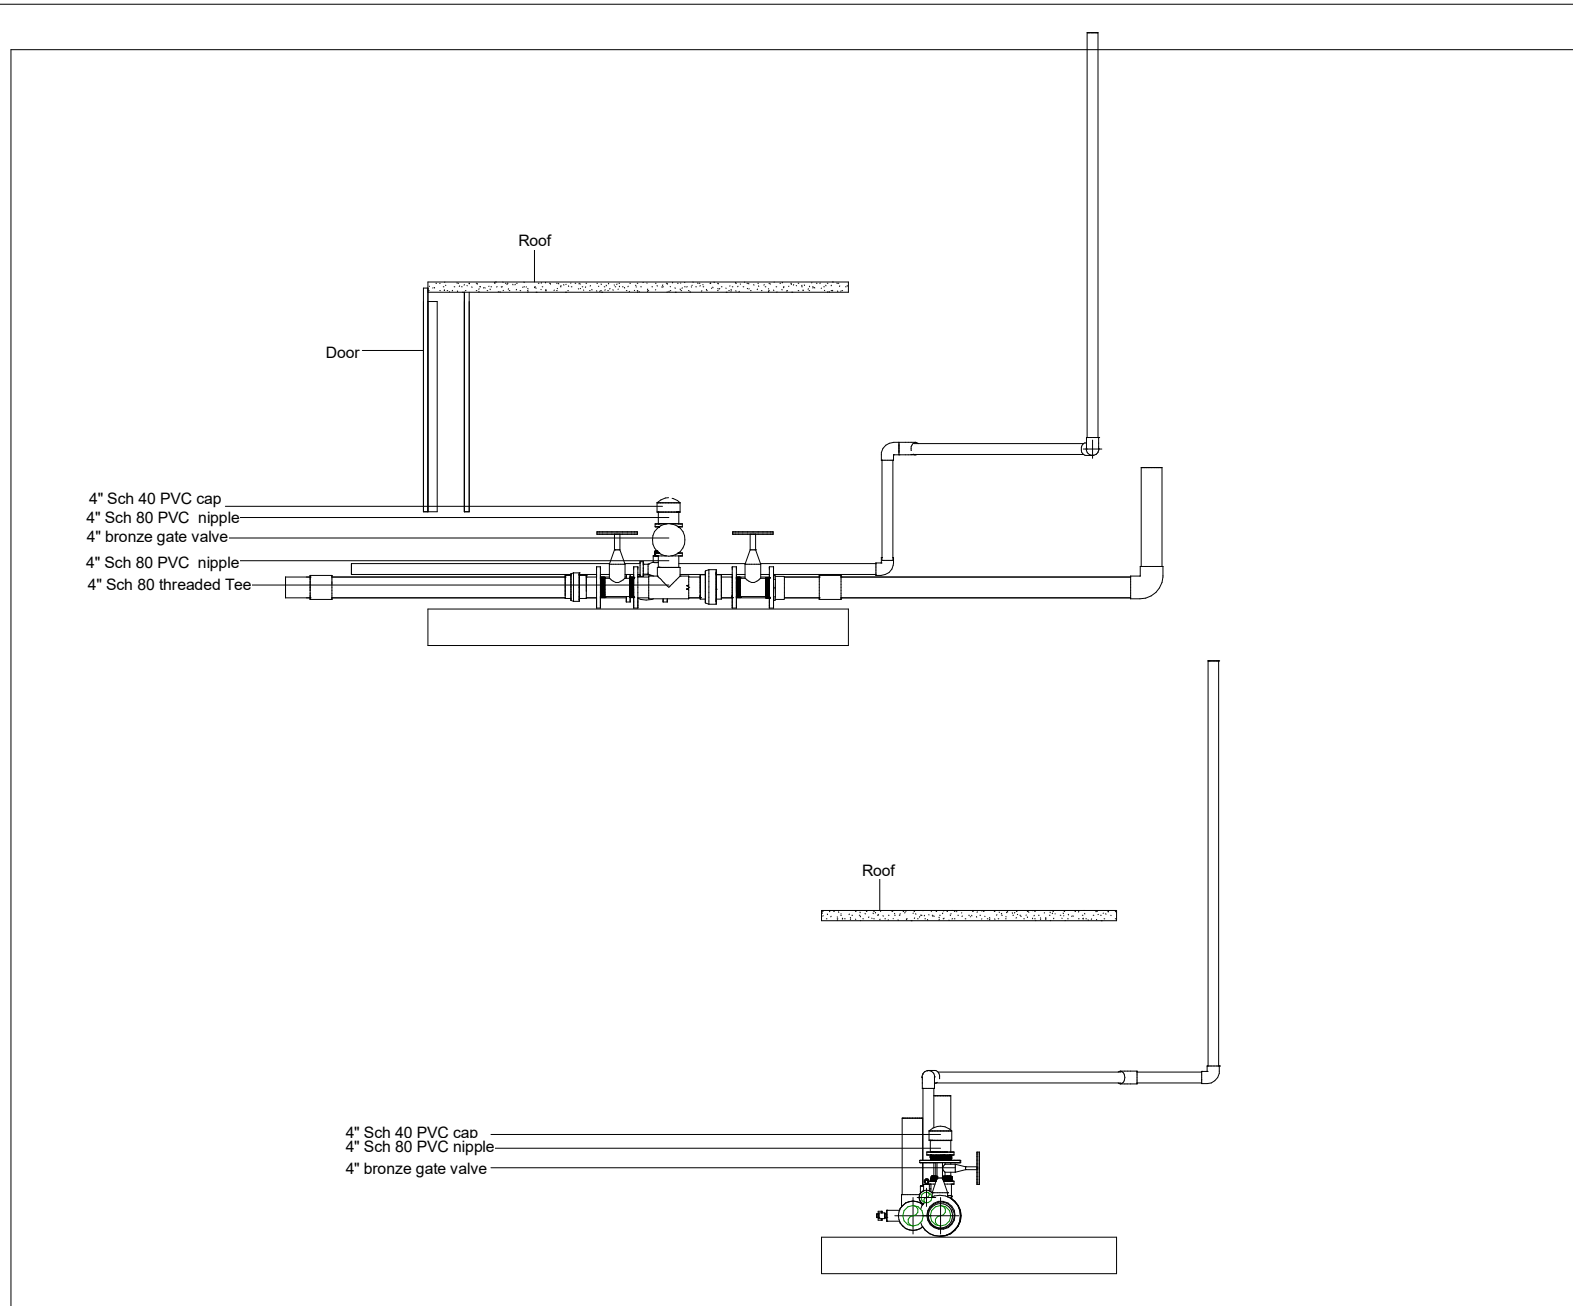

No.	Description	Date

Harvard University  
Los Sanchez Water  
Distribution Project  
**ALTA GRACIA  
PIPING  
DIMENSIONS**

Project Number	AS-BUILT 1
Date	2/23/2018
Drawn By	Billy Koech
Checked By	

**A108**

Scale 1 : 10







www.autodesk.com/evit

Consultant  
Address  
Address  
Phone

Consultant  
Address  
Address  
Phone

No.	Description	Date

Harvard University  
Los Sanchez Water  
Distribution Project

### 3D PIPE CONNECTIONS

Project Number	AS-BUILT 1
Date	2/23/2018
Drawn By	Billy Koech

Checked By	
Scale	A110

3/22/2018 12:08:31 PM

